


LEGEND

	WATER FIRE HYDRANT
	WATER TEE
	Ø20 WATER METER
	WATER BEND
	WATER ISOLATION VALVE
	WATER READY TAP
	WATER TAPER
	WATER CONDUIT CROSSING


NOTES
 -ALL WATER RETICULATION PIPES ARE PVC-0 PN16 U.N.O.
 -ALL FIRE HYDRANTS ARE Ø100 SPRING U.N.O.
 -ALL WATER SERVICE CROSSING CONDUITS ARE Ø100 uPVC PN9 U.N.O.
 -ALL PE-100 WATER MAIN CROSSING PIPES ARE CLASS PN16 U.N.O.
 -ALL DICL WATER MAIN CROSSING PIPES ARE CLASS PN35 U.N.O.

ENGINEER'S CERTIFICATION
 I, _____, hereby certify that:
 1. The information contained in this drawing / document is in compliance with approved drawings and design.
 2. The new water and sewerage works defined by this drawing have been designed and constructed in accordance with the SEQ Code.
 3. This represents an accurate record of as-constructed works
 4. I accept responsibility for the information contained in this drawing / document.
 RPEQ (signature) RPEQ No. _____ Date: _____

REGISTERED SURVEYOR'S CERTIFICATION
 I, LandPartners Pty Ltd, hereby certify that the vertical and horizontal locations and dimensions shown on this plan are a true and correct record and were located by survey.
 R. G. Andrew Authorised Delegate
 Registered Surveyor (sig) Reg Surveyor No. S4118 Date: 11/06/2024

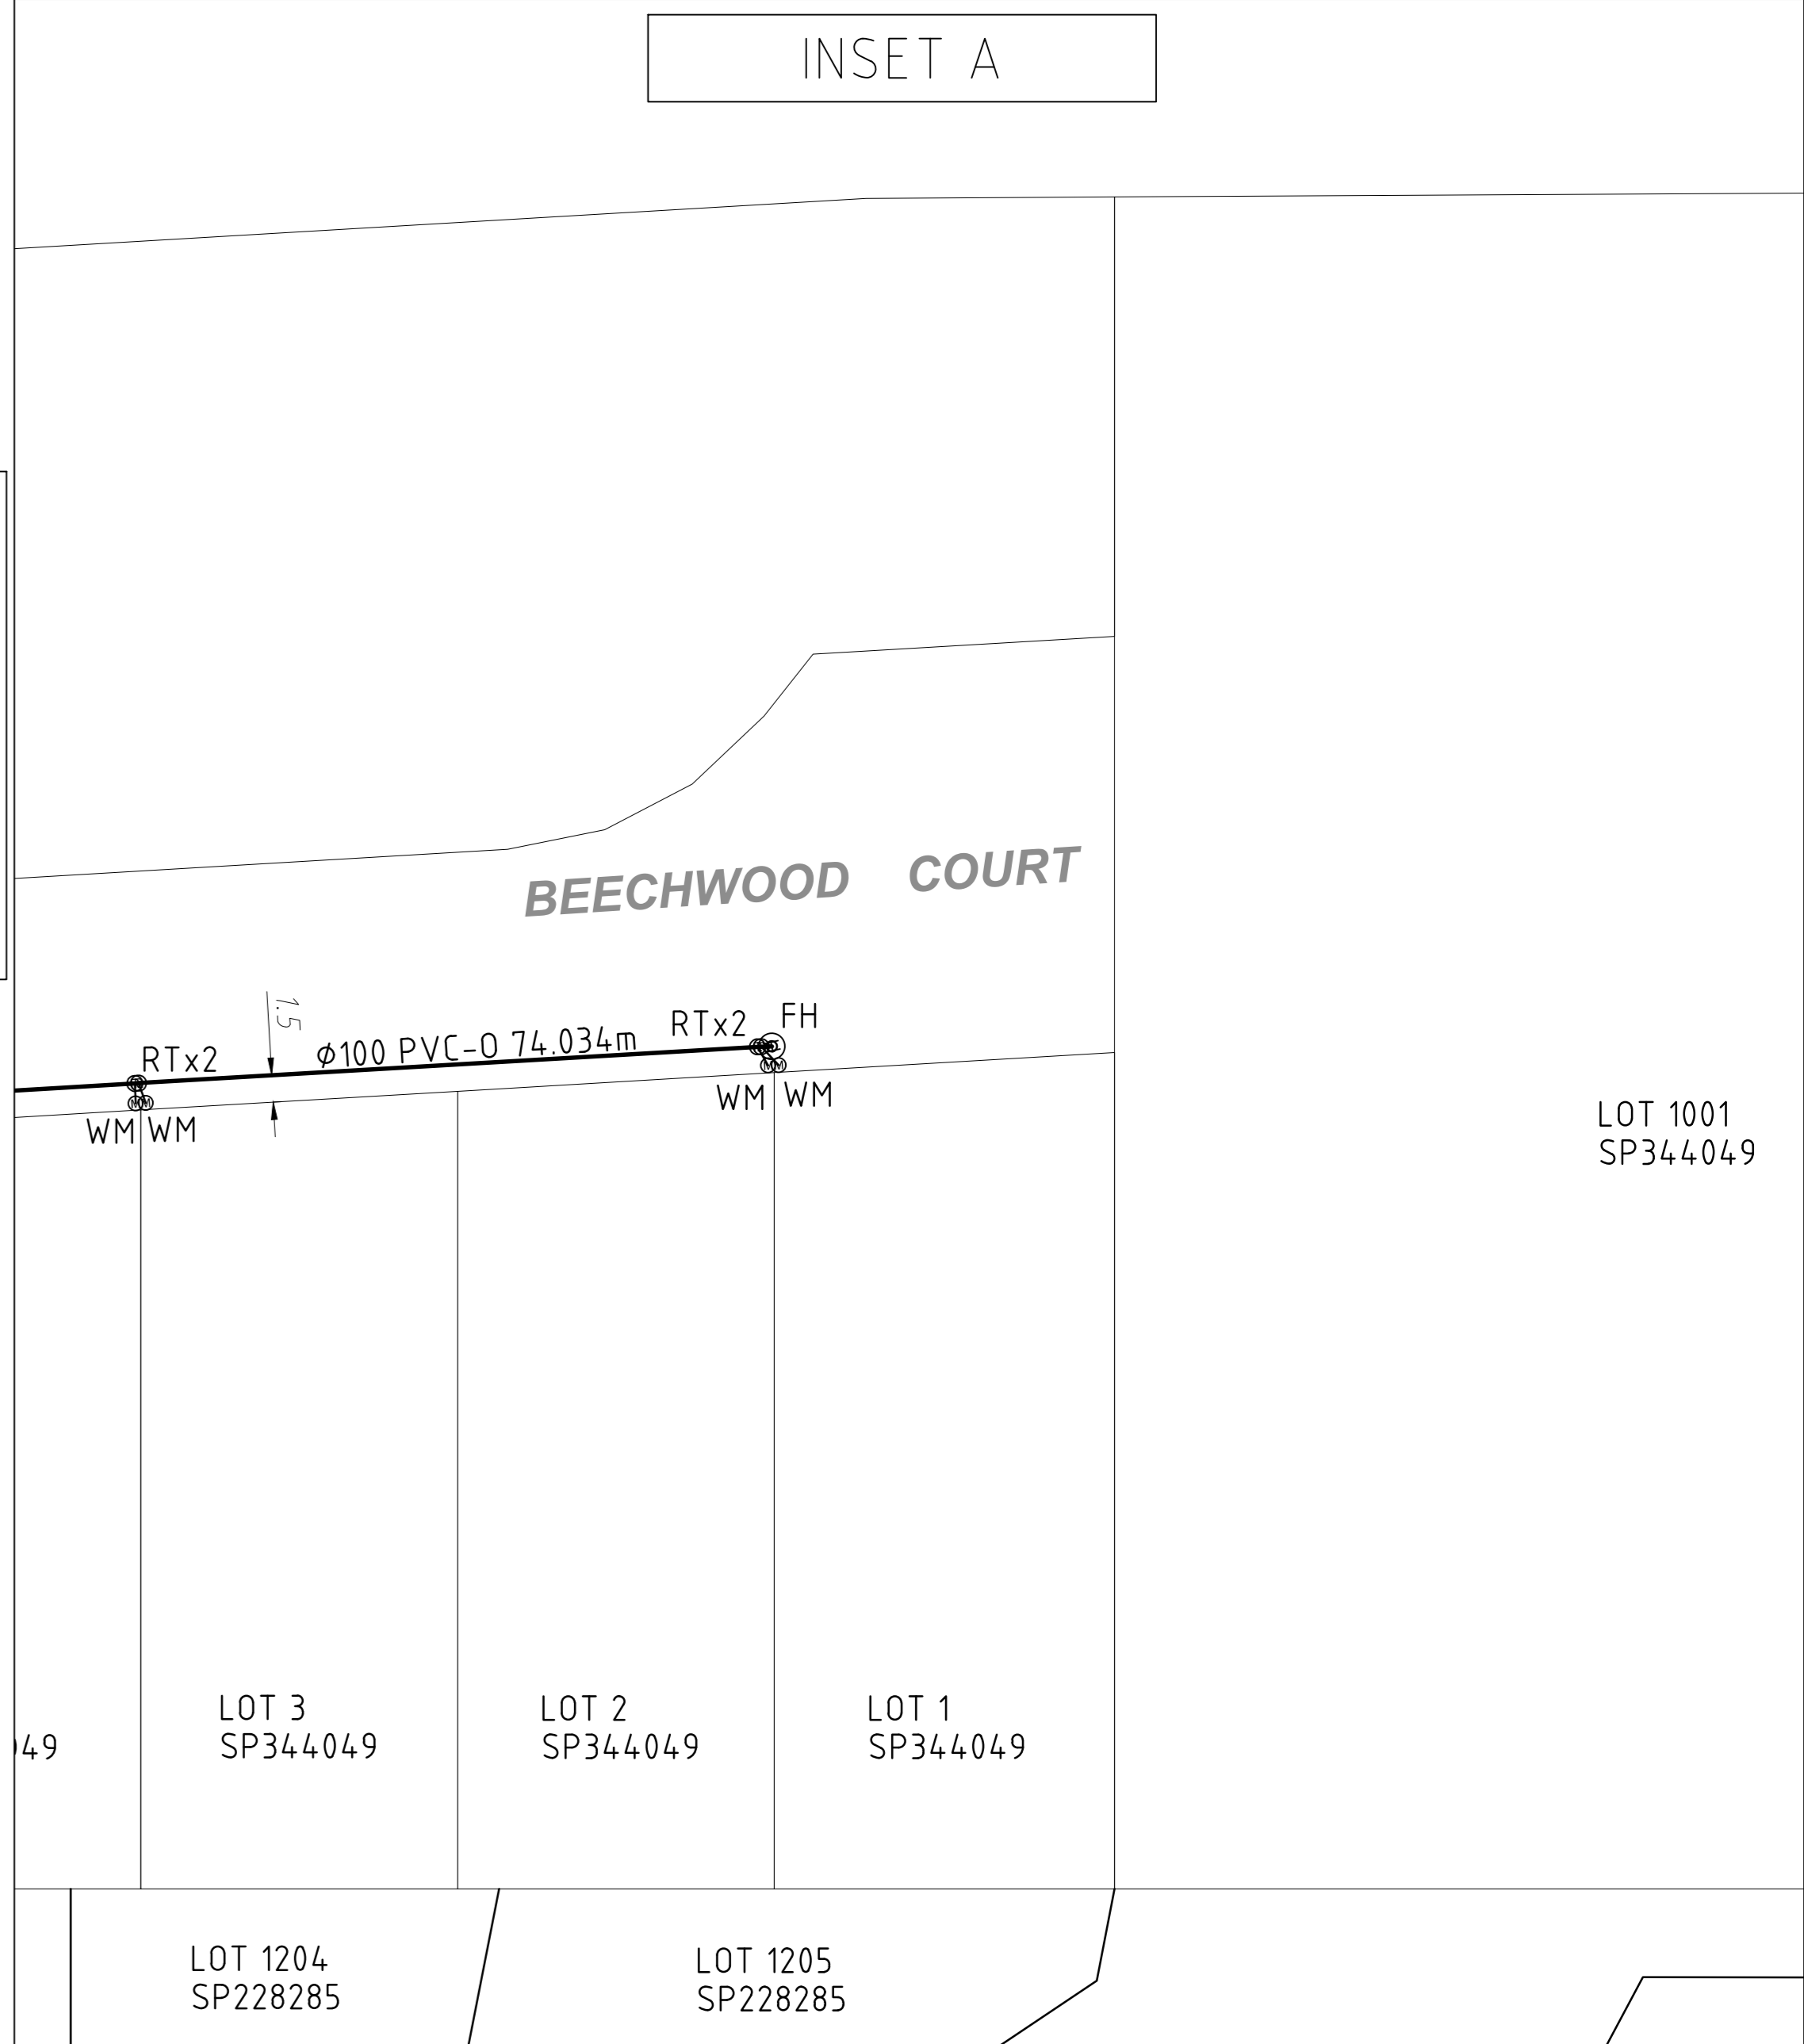

COORDINATE DATUM NOTE:
 HORIZONTAL COORDINATES(E,N) SUPPLIED ARE MAPPING GRID OF AUSTRALIA(MGA), ZONE 56 BASED ON THE UNIVERSAL TRANSVERSE MERCATOR PROJECTION AND THE GEOCENTRIC DATUM OF AUSTRALIA 2020.

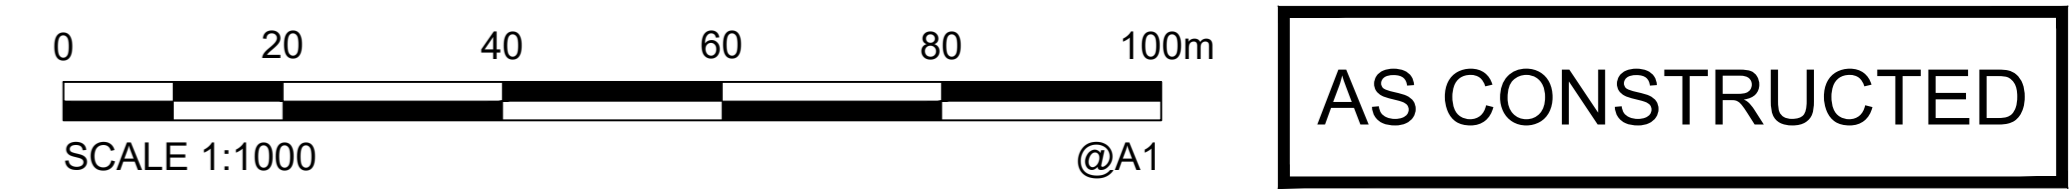

AS CONSTRUCTED

A1	2	11-06-2024	LABEL AMENDMENTS	MJK	RA	RA	DRAWN	MJK	11-06-2024
	1	31-05-2024	INITIAL ISSUE	MJK	RA	RA	CHECKED	RA	11-06-2024
	INDEX		DATE	REVISIONS	DRAWN	CHECKED	PASSED	INITIALS	DATE

Brisbane Office
 Level 1
 16 Little Crab Street
 Milton QLD 4064
 PO Box 1399
 Milton QLD 4064
 p: (07) 3842 1000
 f: (07) 3842 1001
 e: info@landpartners.com.au
 w: www.landpartners.com.au



Unitywater

20230228350
 393 CABOOLTURE RIVER ROAD
 AS CONSTRUCTED SEWER
 UPPER CABOOLTURE

SHEET 1 OF 1 SHEETS	SCALE 1:1000
REVISION DATE 11-06-2024	REVISION 2
DISCIPLINE CODE C	
DRAWING NO. U-2023-5214	